

REVISIONS	
NO.	DATE
1	8/25/04
2	8/25/04
3	8/25/04
4	8/25/04

DATE	8/25/04
BY	J. HELLER
CHECKED BY	S. WISE

studio5 architects, LLC
 302 E. Roseville Road, Lancaster, PA 17605
 Tel: 717-791-2200 Fax: 717-791-2201

HIGH ASSOCIATES, LTD.
CONSTRUCTION SERVICES GROUP
 1533 William Penn Way
 Lancaster, Pennsylvania 17605
 Phone: 717/501-2204

RENOVATIONS TO
MID ATLANTIC FARM
CREDIT UNION
 411 W. ROSEVILLE ROAD
 LANCASTER, PA.

EXISTING LOWER & UPPER FLOOR PLANS
 PROJECT NAME
 E.S.A. JOB NO.
 040802
 DRAWING NO.
A-1.4


GENERAL NOTES:

- FINAL OUTLET LOCATIONS TO BE PER FINAL FURNITURE PLAN.
- OUTLETS ABOVE 18" A.F.F. IN OFFICE AREAS TO BE LOCATED TO 18" A.F.F.
- PROVIDE NEW LAYER OF 1/2" GYP. BD. WHERE EXISTING WOOD PANELING IS REMOVED. RE-TRIM WINDOWS & EXTEND NEW OUTLETS OUT AS REQUIRED BY NEW THICKNESS OF GYP. BD.
- REMOVE EXISTING WOOD PANELS & CHAIR RAIL. PATCH & REPAIR WALLS & WINDOW SILLCASING TO RECEIVE NEW FINISHES.
- CHANGE EXISTING BROWN OUTLETS TO IVORY/ALMOND COLOR.
- AREA OF NEW IMPERVIOUS - 156 SQ.FT.
 AREA OF NEW LANDSCAPING - 182 SQ.FT.
- PROVIDE 1 HR. FIRE RATED CEILING ASSEMBLY IN VESTIBULE 100 & STAIR 1, BASED ON UL-P522.

PROPOSED UPPER LEVEL FLOOR PLAN
 SCALE: 1/8"=1'-0"



Tr. Pch sec. & UL FL. PL.

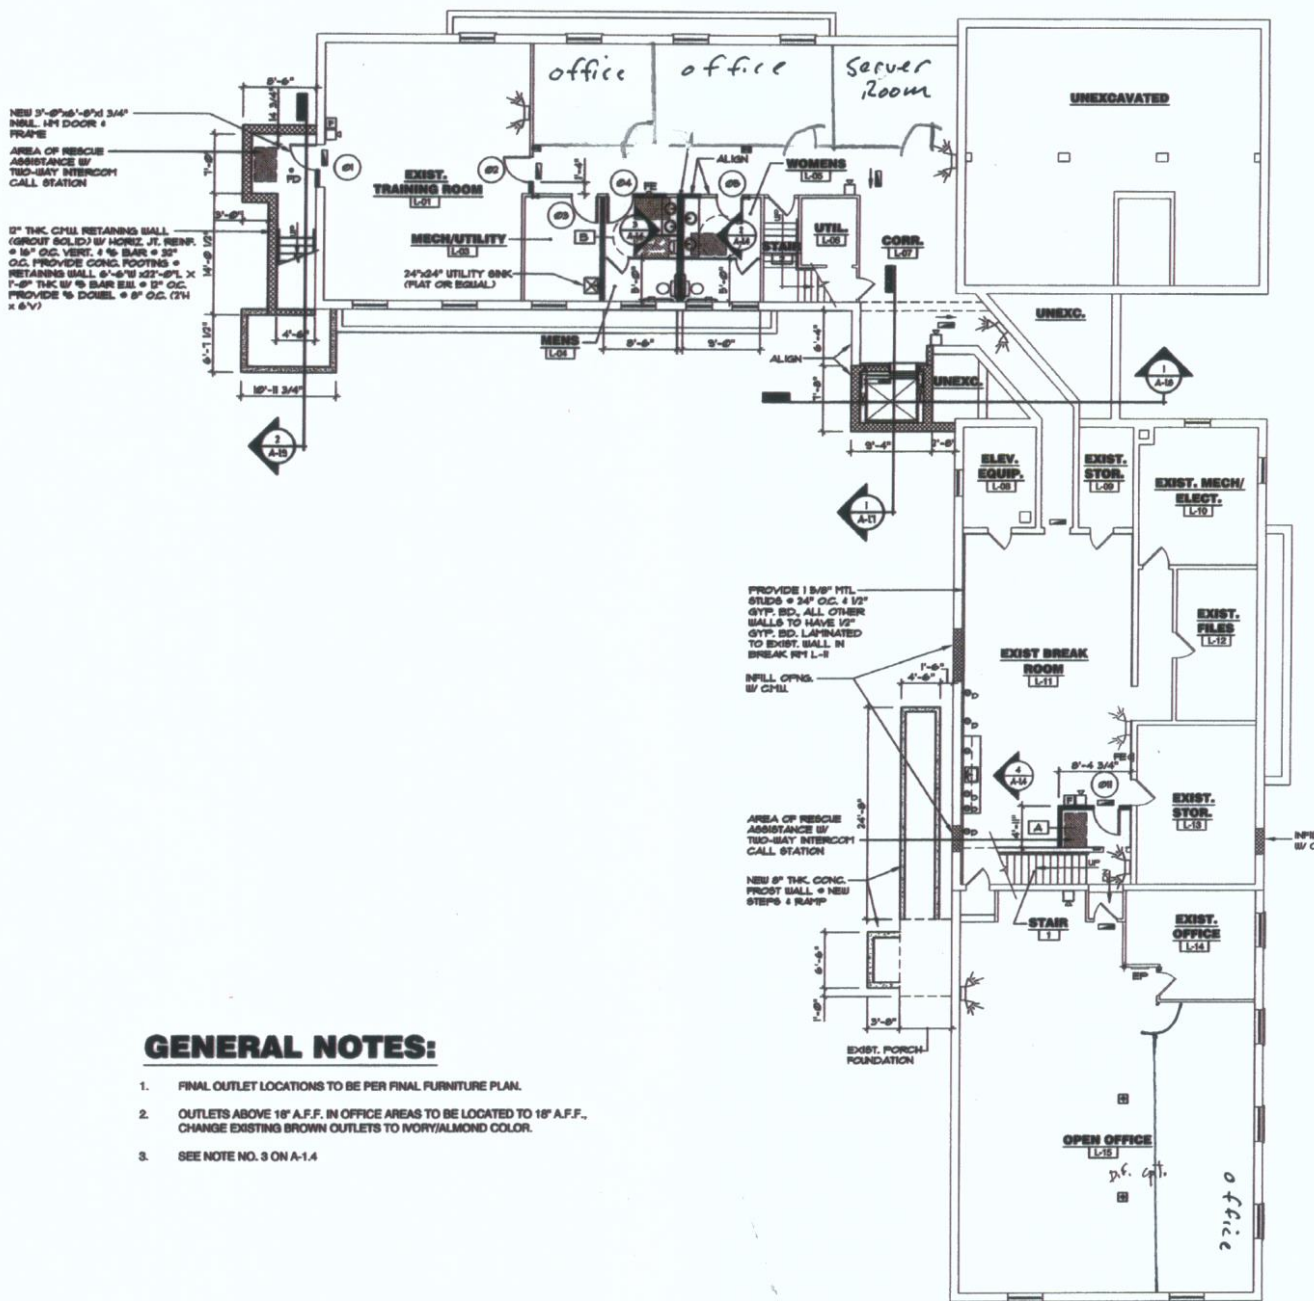

GENERAL NOTES:

1. FINAL OUTLET LOCATIONS TO BE PER FINAL FURNITURE PLAN.
2. OUTLETS ABOVE 18" A.F.F. IN OFFICE AREAS TO BE LOCATED TO 18" A.F.F. CHANGE EXISTING BROWN OUTLETS TO IVORY/ALMOND COLOR.
3. SEE NOTE NO. 3 ON A-1.4



1

PROPOSED LOWER LEVEL FLOOR PLAN

SCALE: 1/8"=1'-0"



NO.	DATE	DESCRIPTION
1	8/20/04	ISSUED FOR PRELIM. REVIEW
2	8/27/04	ISSUED FOR PRELIM. TYP. REVIEW
3	11/20/04	80% REVIEW
4	11/21/04	ISSUED FOR PERMIT REVIEW

REVISIONS

NO. DATE DESCRIPTION

1 8/20/04 ISSUED FOR PRELIM. REVIEW

2 8/27/04 ISSUED FOR PRELIM. TYP. REVIEW

3 11/20/04 80% REVIEW

4 11/21/04 ISSUED FOR PERMIT REVIEW

5 11/22/04 ISSUED FOR PERMIT REVIEW

6 11/23/04 ISSUED FOR PERMIT REVIEW

7 11/24/04 ISSUED FOR PERMIT REVIEW

8 11/25/04 ISSUED FOR PERMIT REVIEW

9 11/26/04 ISSUED FOR PERMIT REVIEW

10 11/27/04 ISSUED FOR PERMIT REVIEW

11 11/28/04 ISSUED FOR PERMIT REVIEW

12 11/29/04 ISSUED FOR PERMIT REVIEW

13 11/30/04 ISSUED FOR PERMIT REVIEW

14 12/1/04 ISSUED FOR PERMIT REVIEW

15 12/2/04 ISSUED FOR PERMIT REVIEW

16 12/3/04 ISSUED FOR PERMIT REVIEW

44 12/31/04 ISSUED FOR PERMIT REVIEW

45 1/1/05 ISSUED FOR PERMIT REVIEW

46 1/2/05 ISSUED FOR PERMIT REVIEW

47 1/3/05 ISSUED FOR PERMIT REVIEW

75 1/31/05 ISSUED FOR PERMIT REVIEW

76 2/1/05 ISSUED FOR PERMIT REVIEW

77 2/2/05 ISSUED FOR PERMIT REVIEW

78 2/3/05 ISSUED FOR PERMIT REVIEW

79 2/4/05 ISSUED FOR PERMIT REVIEW

80 2/5/05 ISSUED FOR PERMIT REVIEW

81 2/6/05 ISSUED FOR PERMIT REVIEW

82 2/7/05 ISSUED FOR PERMIT REVIEW

83 2/8/05 ISSUED FOR PERMIT REVIEW

84 2/9/05 ISSUED FOR PERMIT REVIEW

85 2/10/05 ISSUED FOR PERMIT REVIEW

86 2/11/05 ISSUED FOR PERMIT REVIEW

87 2/12/05 ISSUED FOR PERMIT REVIEW

88 2/13/05 ISSUED FOR PERMIT REVIEW

89 2/14/05 ISSUED FOR PERMIT REVIEW

90 2/15/05 ISSUED FOR PERMIT REVIEW

91 2/16/05 ISSUED FOR PERMIT REVIEW

163 4/27/05 ISSUED FOR PERMIT REVIEW

164 4/28/05 ISSUED FOR PERMIT REVIEW

165 4/29/05 ISSUED FOR PERMIT REVIEW

166 4/30/05 ISSUED FOR PERMIT REVIEW

167 5/1/05 ISSUED FOR PERMIT REVIEW

168 5/2/05 ISSUED FOR PERMIT REVIEW

169 5/3/05 ISSUED FOR PERMIT REVIEW

197 5/31/05 ISSUED FOR PERMIT REVIEW

198 6/1/05 ISSUED FOR PERMIT REVIEW

199 6/2/05 ISSUED FOR PERMIT REVIEW

200 6/3/05 ISSUED FOR PERMIT REVIEW